




ELEVATION 1

DATUM 25.00

SURVEY KEY

| LINE TYPE | DESCRIPTION |
|-----------|--------------------|
| — | BUILDING LINE |
| — | WALL |
| — | ROOF DETAIL |
| — | CHIMNEY |
| — | BARGE BOARD |
| — | RAINWATER PIPE |
| — | SOIL VENT PIPE |
| — | WINDOW OPENING |
| — | WINDOW FRAME |
| — | WINDOW GLAZING |
| — | DOOR OPENING |
| — | DOOR FRAME |
| — | DOOR GLAZING |
| — | SIGNAGE |
| — | MOULDING |
| — | ELECTRICITY CABLES |
| — | GROUND LINE |
| — | FENCE LINE |

- NOTES**
- ALL LEVELS RELATE TO ORDNANCE SURVEY DATUM (MALIN HEAD DATUM)
 - ALL DIMENSIONS ARE IN METERS
 - DO NOT SCALE FROM PLOT

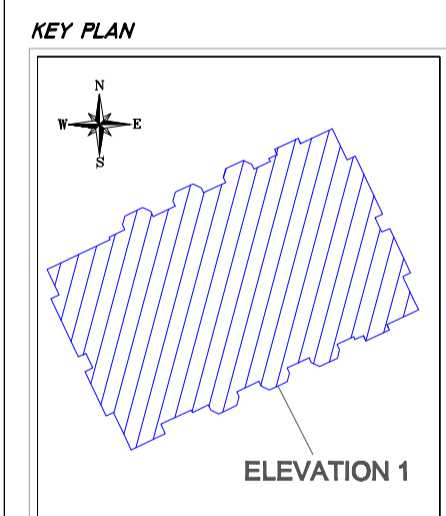

AMENDMENTS

| REV | DATE | CK | AP | DESCRIPTION |
|-----|------|----|----|-------------|
| | | | | |

Complete Survey Solutions

DONEGALL, MALLOW, CO. DK
 Tel: 022 22042 | Mobile: 084 13542
 Fax: 022 22052 | Email: info@csolutions.ie
 Web: www.csolutions.ie

SURVEYING SERVICES PROVIDED

| | |
|---------------------------|-----------------------|
| TOPOGRAPHICAL SURVEYS | AS BUILT SURVEYS |
| BOUNDARY BUILDING SURVEYS | DEFORMATIONAL SURVEYS |
| GPS SURVEYS | VOLUME/FIELD SURVEYS |
| SETTING OUT | LEGAL MAPPING |

CLIENT

PROJECT/LOCATION: **SAMPLE SURVEY**

TITLE

| SCALE | SURVEYED BY | DRAWN | CHECKED | APPROVED |
|-------|-------------|-------|---------|----------|
| | | | | |

PROJECT NO. DRAWING NO. SHEET