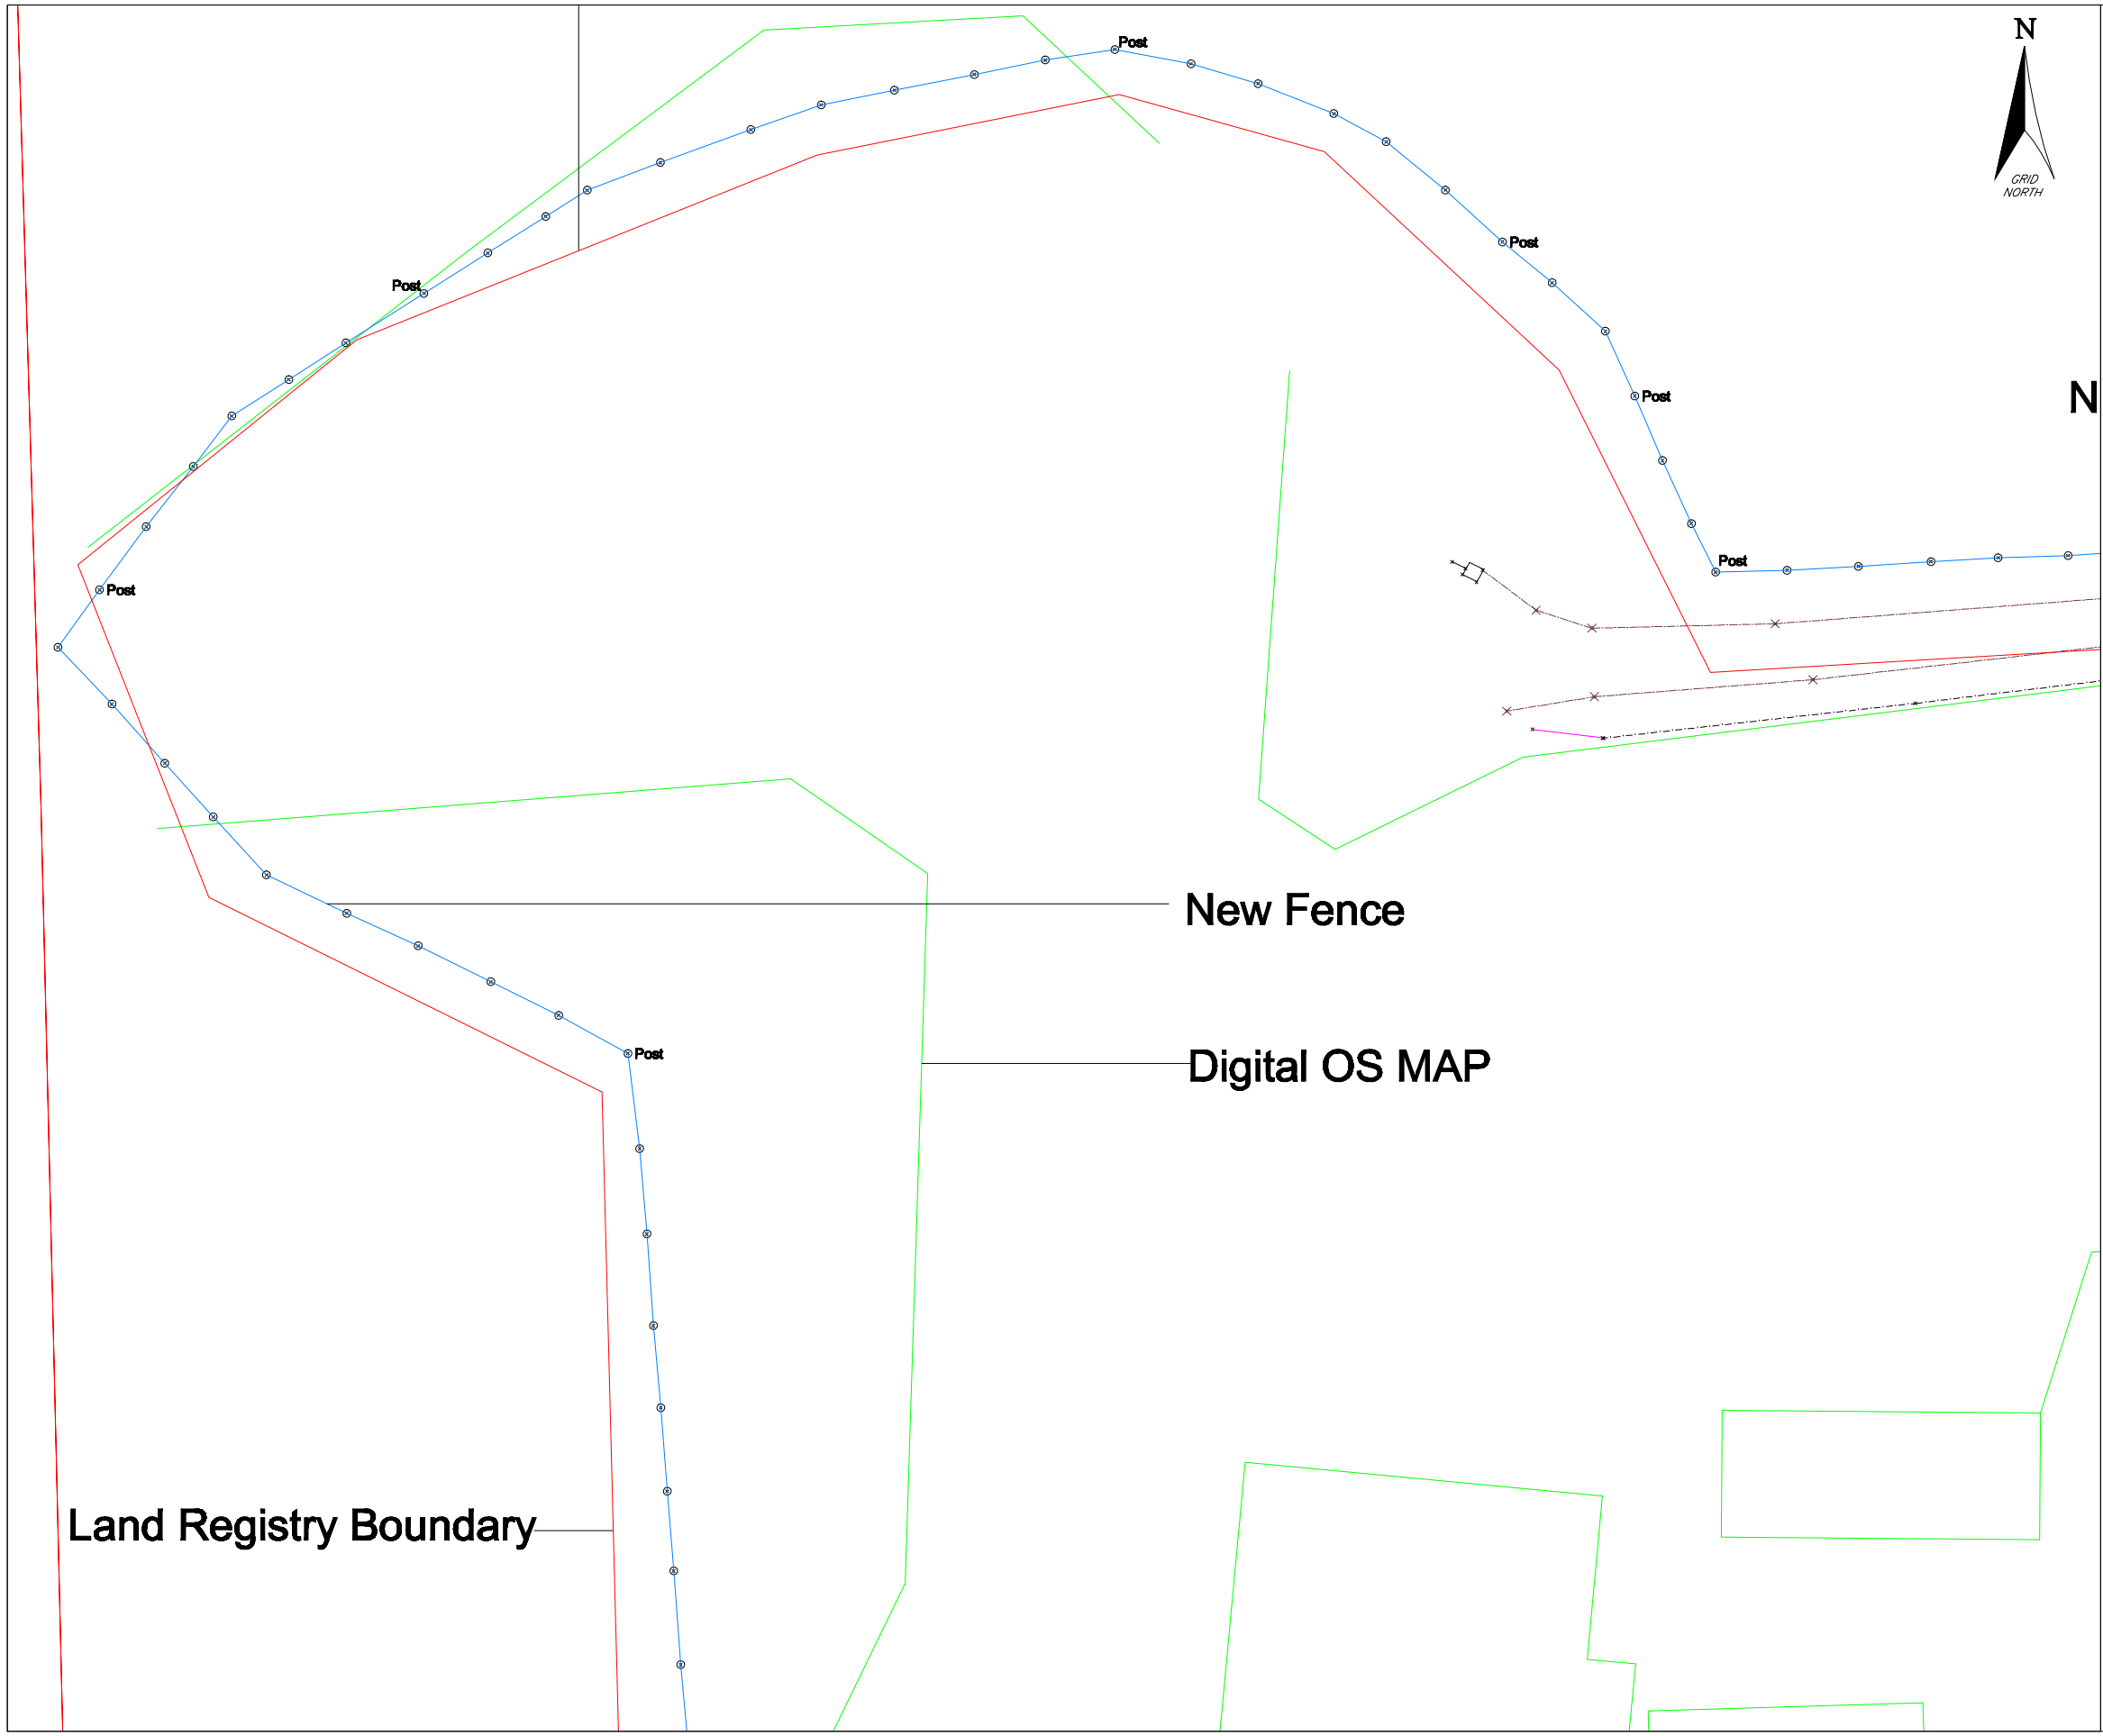

SURVEY KEY

SERVICES

MHS	MANHOLE SQUARE	MHR	MANHOLE ROUND	EMH	ESB MANHOLE
TEL	TELECOM MANHOLE	IC	INSPECION CHAMBER	GY	GULLY
SV	SLUICE VALVE	SC	STOP COCK	WM	WATER METER
FH	FIRE HYDRANT	EP	ELECTRICITY POLE	TP	TELEGRAPH POLE
AV	AIR VALVE				

HEIGHTS

IL	INVERT LEVEL	BL	BED LEVEL	WL	WATER LEVEL
CL	COVER LEVEL	WH	WALL HEIGHT	FT	HEIGHT OF FENCE
HOW	HEIGHT OF OVERHEAD WIRES	FFL	FINISHED FLOOR LEVEL	TH	TREE HEIGHT

MISCELLANEOUS

STN	SURVEY STATION	BM	BENCH MARK	RS	ROAD SIGN
LS	LAMP STANDARD	U/G	UNDERGROUND	TL	TRAFFIC LIGHT
SPR	SPREAD OF TREE	GIR	GIRTH OF TREE	BOL	BOLLARD

LINE TYPE

BUILDING LINE		WALL	
FENCE LINE		SOD & STONE WALL	
EDGE OF CONCRETE		CL OF BOUNDARY	
ROAD		OH ESB WIRES	
KERB		OH TELECOM WIRES	
BANK BOTTOM		TRACK	
BANK TOP		EDGE OF VEGETATION	
MAJOUR CONTOUR	25	DRIP LINE	
INTERVAL CONTOUR		PIPE	
		TANK	

NOTES

- ALL LEVELS RELATE TO ORDANANCE SURVEY DATUM (MALIN HEAD DATUM)
- CORDINATES RELATE TO IRISH NATIONAL GRID,NORTH REFERS TO GRID NORTH.
- ALL DIMENSIONS ARE IN METERS
- DO NOT SCALE FROM PLOT

SITE TBM

LOCATION MAP

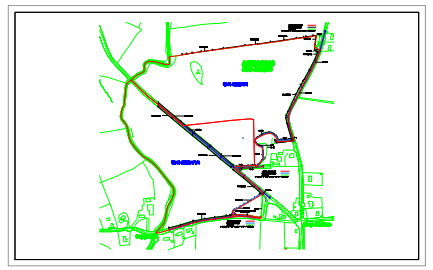

PROJECT CENTRE POINT CORDINATE

- IRISH GRID
- ITM GRID

STATION INFORMATION

STN	STN TYPE	EASTING	NORTHING	ELEVATION

AMMENDMENTS

REV	DATE	CK	AP	DESCRIPTION

Complete Survey Solutions

DONERAILE, MALLOW, CORK.
Tel: 022 72962 | Mobile: 086 158426
Fax: 022 24597 | Email: info@cssolutions.ie
Web: www.cssolutions.ie

SURVEYING SERVICES PROVIDED

TOPOGRAPHICAL SURVEYS
MEASURED BUILDING SURVEYS
GPS SURVEYS
SETTING OUT
AS BUILT SURVEYS
ENGINEERING SURVEYS
VOLUMETRIC SURVEYS
LEGAL MAPPING

CLIENT

PROJECT/LOCATION

TITLE
Boundary Survey

SCALES	SURVEYED BY	DRAWN	CHECKED	APPROVED
	DATE	DATE	DATE	DATE

PROJECT NO.	DRAWING NO .	SHEET